


**TIME WARNER**  
TELECOM

**AS-BUILT  
MADERA REGEN  
TO FRESNO HUB**

DRIVEN BY:  
 -  
 APPROVED BY:  
 -  
 DATES:  
 -  
 MAP REF/CODE:  
 -  
 WORKLOAD HRS:  
 -  
 DRIVING NUMBER:  
**042R433A**  
 DIR OF  
**433**      **506**  
 POLICE:  
 B-322: --  
 D-322: --

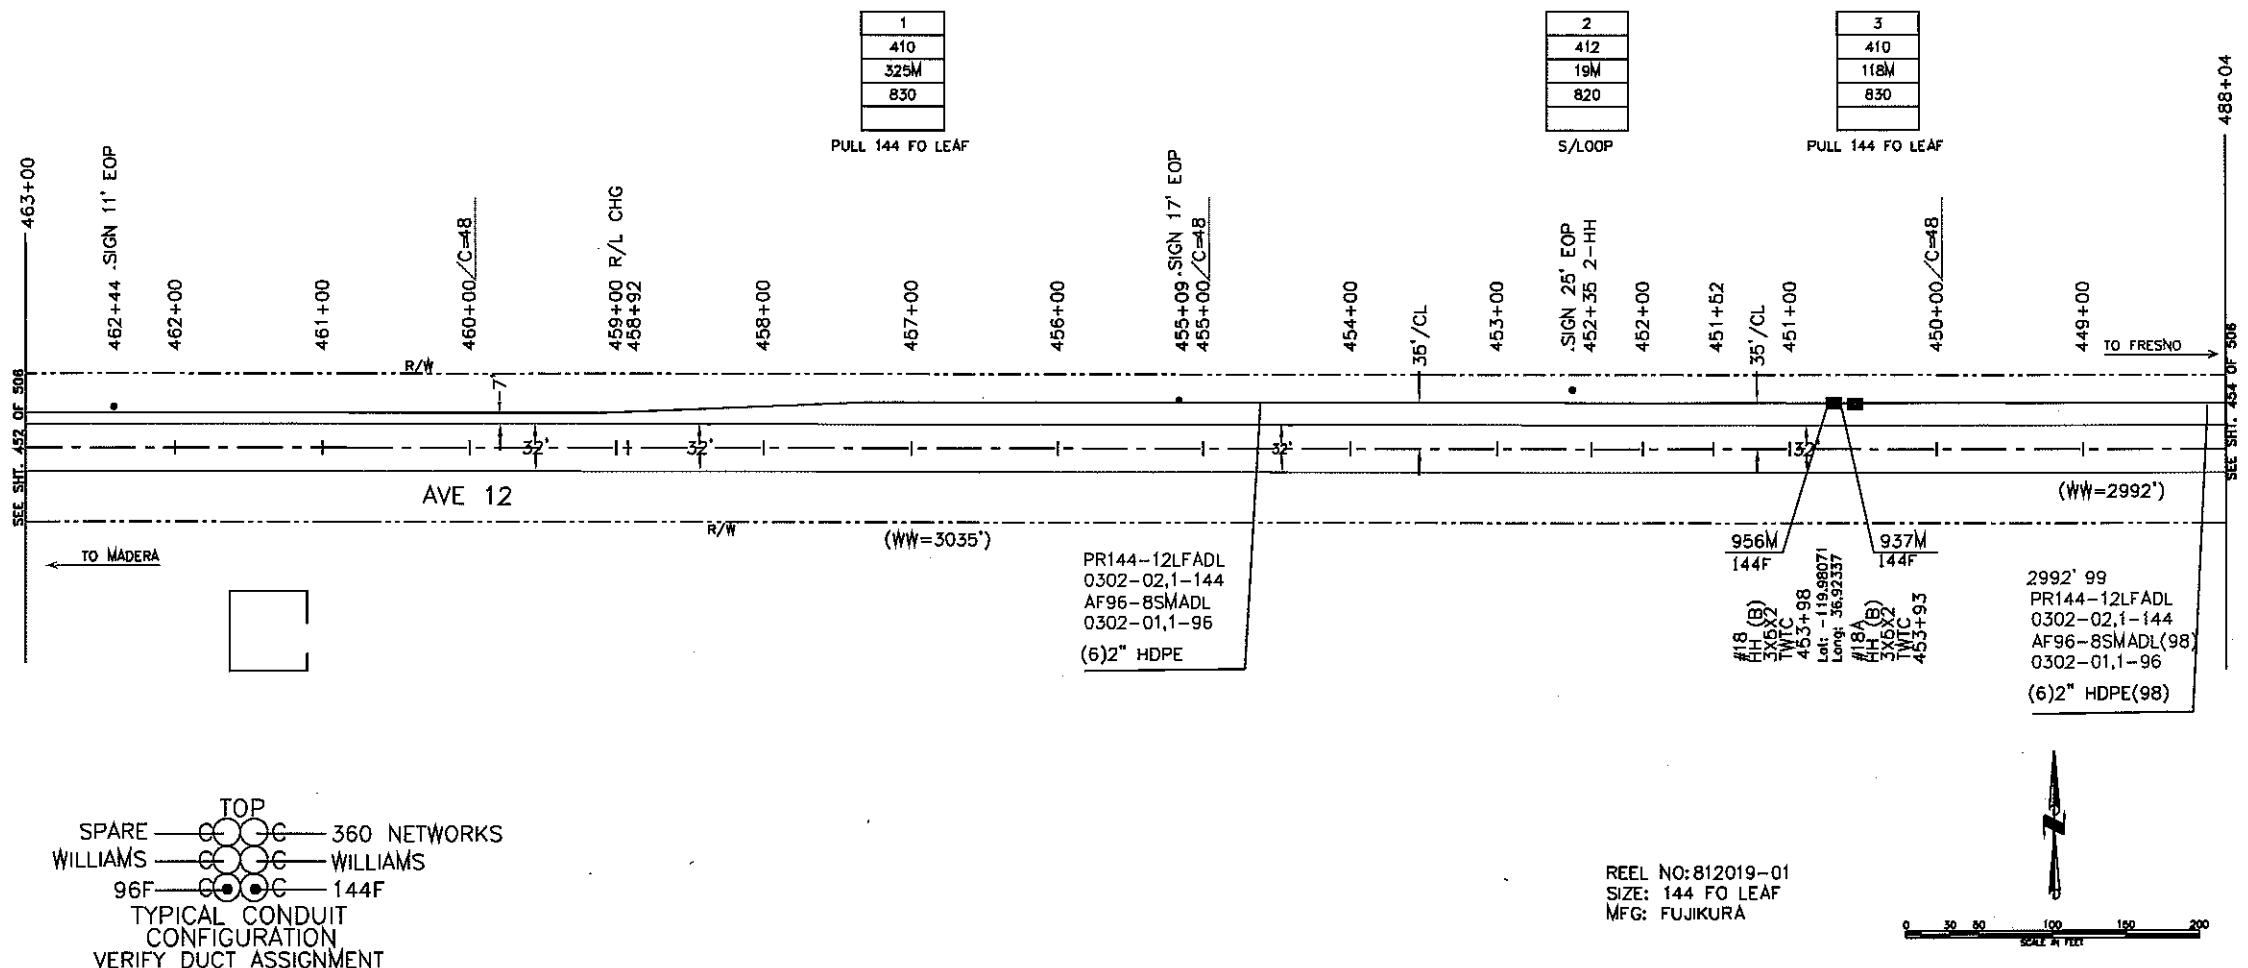

ASSEMBLY UNITS				ASSEMBLY UNITS				ASSEMBLY UNITS				REVISION			DRAWN BY	
UNIT	QUANTITY	ACCT. CODE	DESCRIPTION	UNIT	QUANTITY	ACCT. CODE	DESCRIPTION	UNIT	QUANTITY	ACCT. CODE	DESCRIPTION	REV	DESCRIPTION	DATE	BY	APPROVED BY:
410	1453'	820	PULL 144 FO LEAF													TIME WARNER TELECOM
412	62'	820	S/LOOP													APPROVED BY: DATE: MANAGER SIGN: PROJECT MANAGER SIGN: PHONE NUMBER: 042P453A
250	2	826	HH													453 506 RECALL: B-32D -- D-32G --
																KEYMAP REFERENCES

SEE SHT. 455 OF 506 448+04

447+00

446+00

35' /CL  
445+00 /C=48

444+10  
444+00

443+51 .SIGN 14' EGP

443+00

442+00

441+00

1  
410  
466W  
830

PULL 144 FO LEAF

440+00 /C=48

35' /CL  
439+00

438+68 .SIGN 13' EGP

438+00

437+00

436+70

436+00

435+00 /C=48

434+00

A  
TO FRESNO  
RR  
SEE SHT. 455 OF 506 433+00

AVENUE 12


TO MADERA

TO FRESNO


PR144-12LFADL  
0302-02,1-144  
AF96-8SMADL  
0302-01,1-96  
(6)2" HDPE

TOP  
SPARE ————— C ————— 360 NETWORKS  
WILLIAMS ————— C ————— WILLIAMS  
96F ————— C ————— 144F  
TYPICAL CONDUIT  
CONFIGURATION  
VERIFY DUCT ASSIGNMENT

REEL NO: 812019-01  
SIZE: 144 FO LEAF  
MFG: FUJIKURA

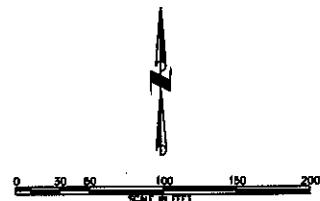

ASSEMBLY UNITS				ASSEMBLY UNITS				ASSEMBLY UNITS				REVISION				TIME WARNER TELECOM	
UNIT	QUANTITY	ACCT. CODE	DESCRIPTION	UNIT	QUANTITY	ACCT. CODE	DESCRIPTION	UNIT	QUANTITY	ACCT. CODE	DESCRIPTION	REV	DESCRIPTION	DATE	BY	APPROVED BY:	DATE:
410	1529'	820	PULL 144 FO LEAF													042P454A	
																BIG 454	506
															SCALE:	E-929	D-929
															KEY MAP REFERENCE		

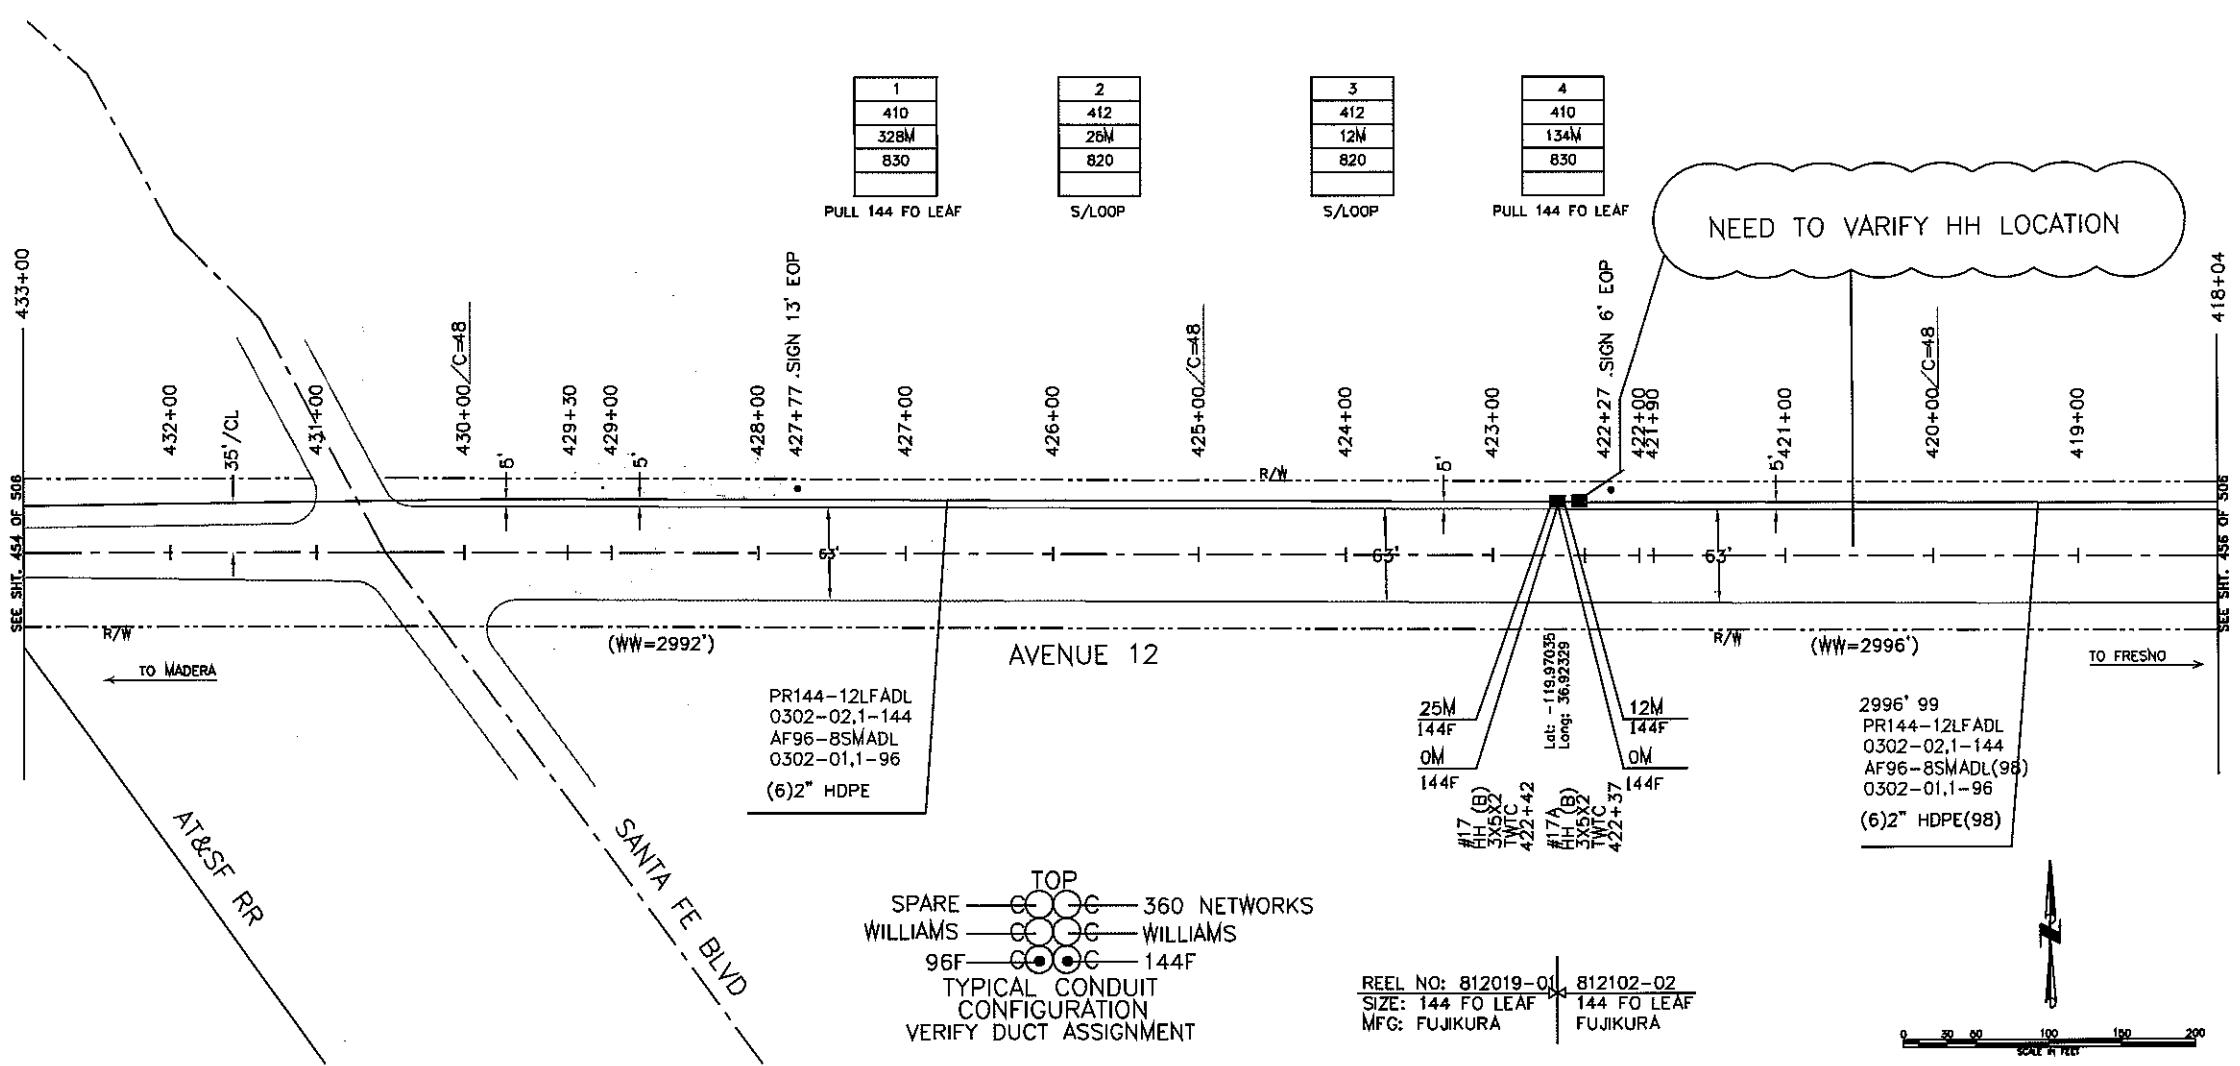

ASSEMBLY UNITS				ASSEMBLY UNITS				ASSEMBLY UNITS				REVISION			
UNIT	QUANTITY	ACCT. CODE	DESCRIPTION	UNIT	QUANTITY	ACCT. CODE	DESCRIPTION	UNIT	QUANTITY	ACCT. CODE	DESCRIPTION	REV	DESCRIPTION	DATE	BY
410	1516'	820	PULL 144 FO LEAF												
412	121'	820	S/LOOP												
250	2	826	HH												

**TIME WARNER**  
TELECOM

AS-BUILT  
MADERA REGEN  
TO FRESNO HUB  
**042P455A**

DRAWN BY	—
APPROVED BY	—
DESIGNER	—
MAP DRAWING	—
CONTRACTOR	—
Supplementary Information	—
REF ID:	042P455A
DRC	455
DRD	506
SCALD	B-320 --
SCALD	D-320 --

KEY MAP REFERENCE